


A graphic scale bar and a north arrow. The scale bar is horizontal and marked with 0, 25, 50, 100, and 150 feet. Below the bar, the text reads "SCALE IN FEET" and "SCALE: 1\"=50'". The north arrow is vertical, pointing upwards, with a decorative swirl and the word "North" written vertically along its shaft.



KING SURVEYORS
650 E. Garden Drive | Windsor, Colorado 80550
phone: (970) 686-5011 | email: contact@kingsurveyors.com

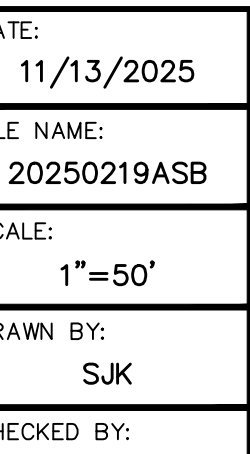

DATE:	REVISIONS:

UTILITY AS BUILT
FOR
GLH CONSTRUCTION
37TH STREET WIDENING PHASE 2B
EVANS, COLORADO

PROJECT #:	20250219
------------	----------