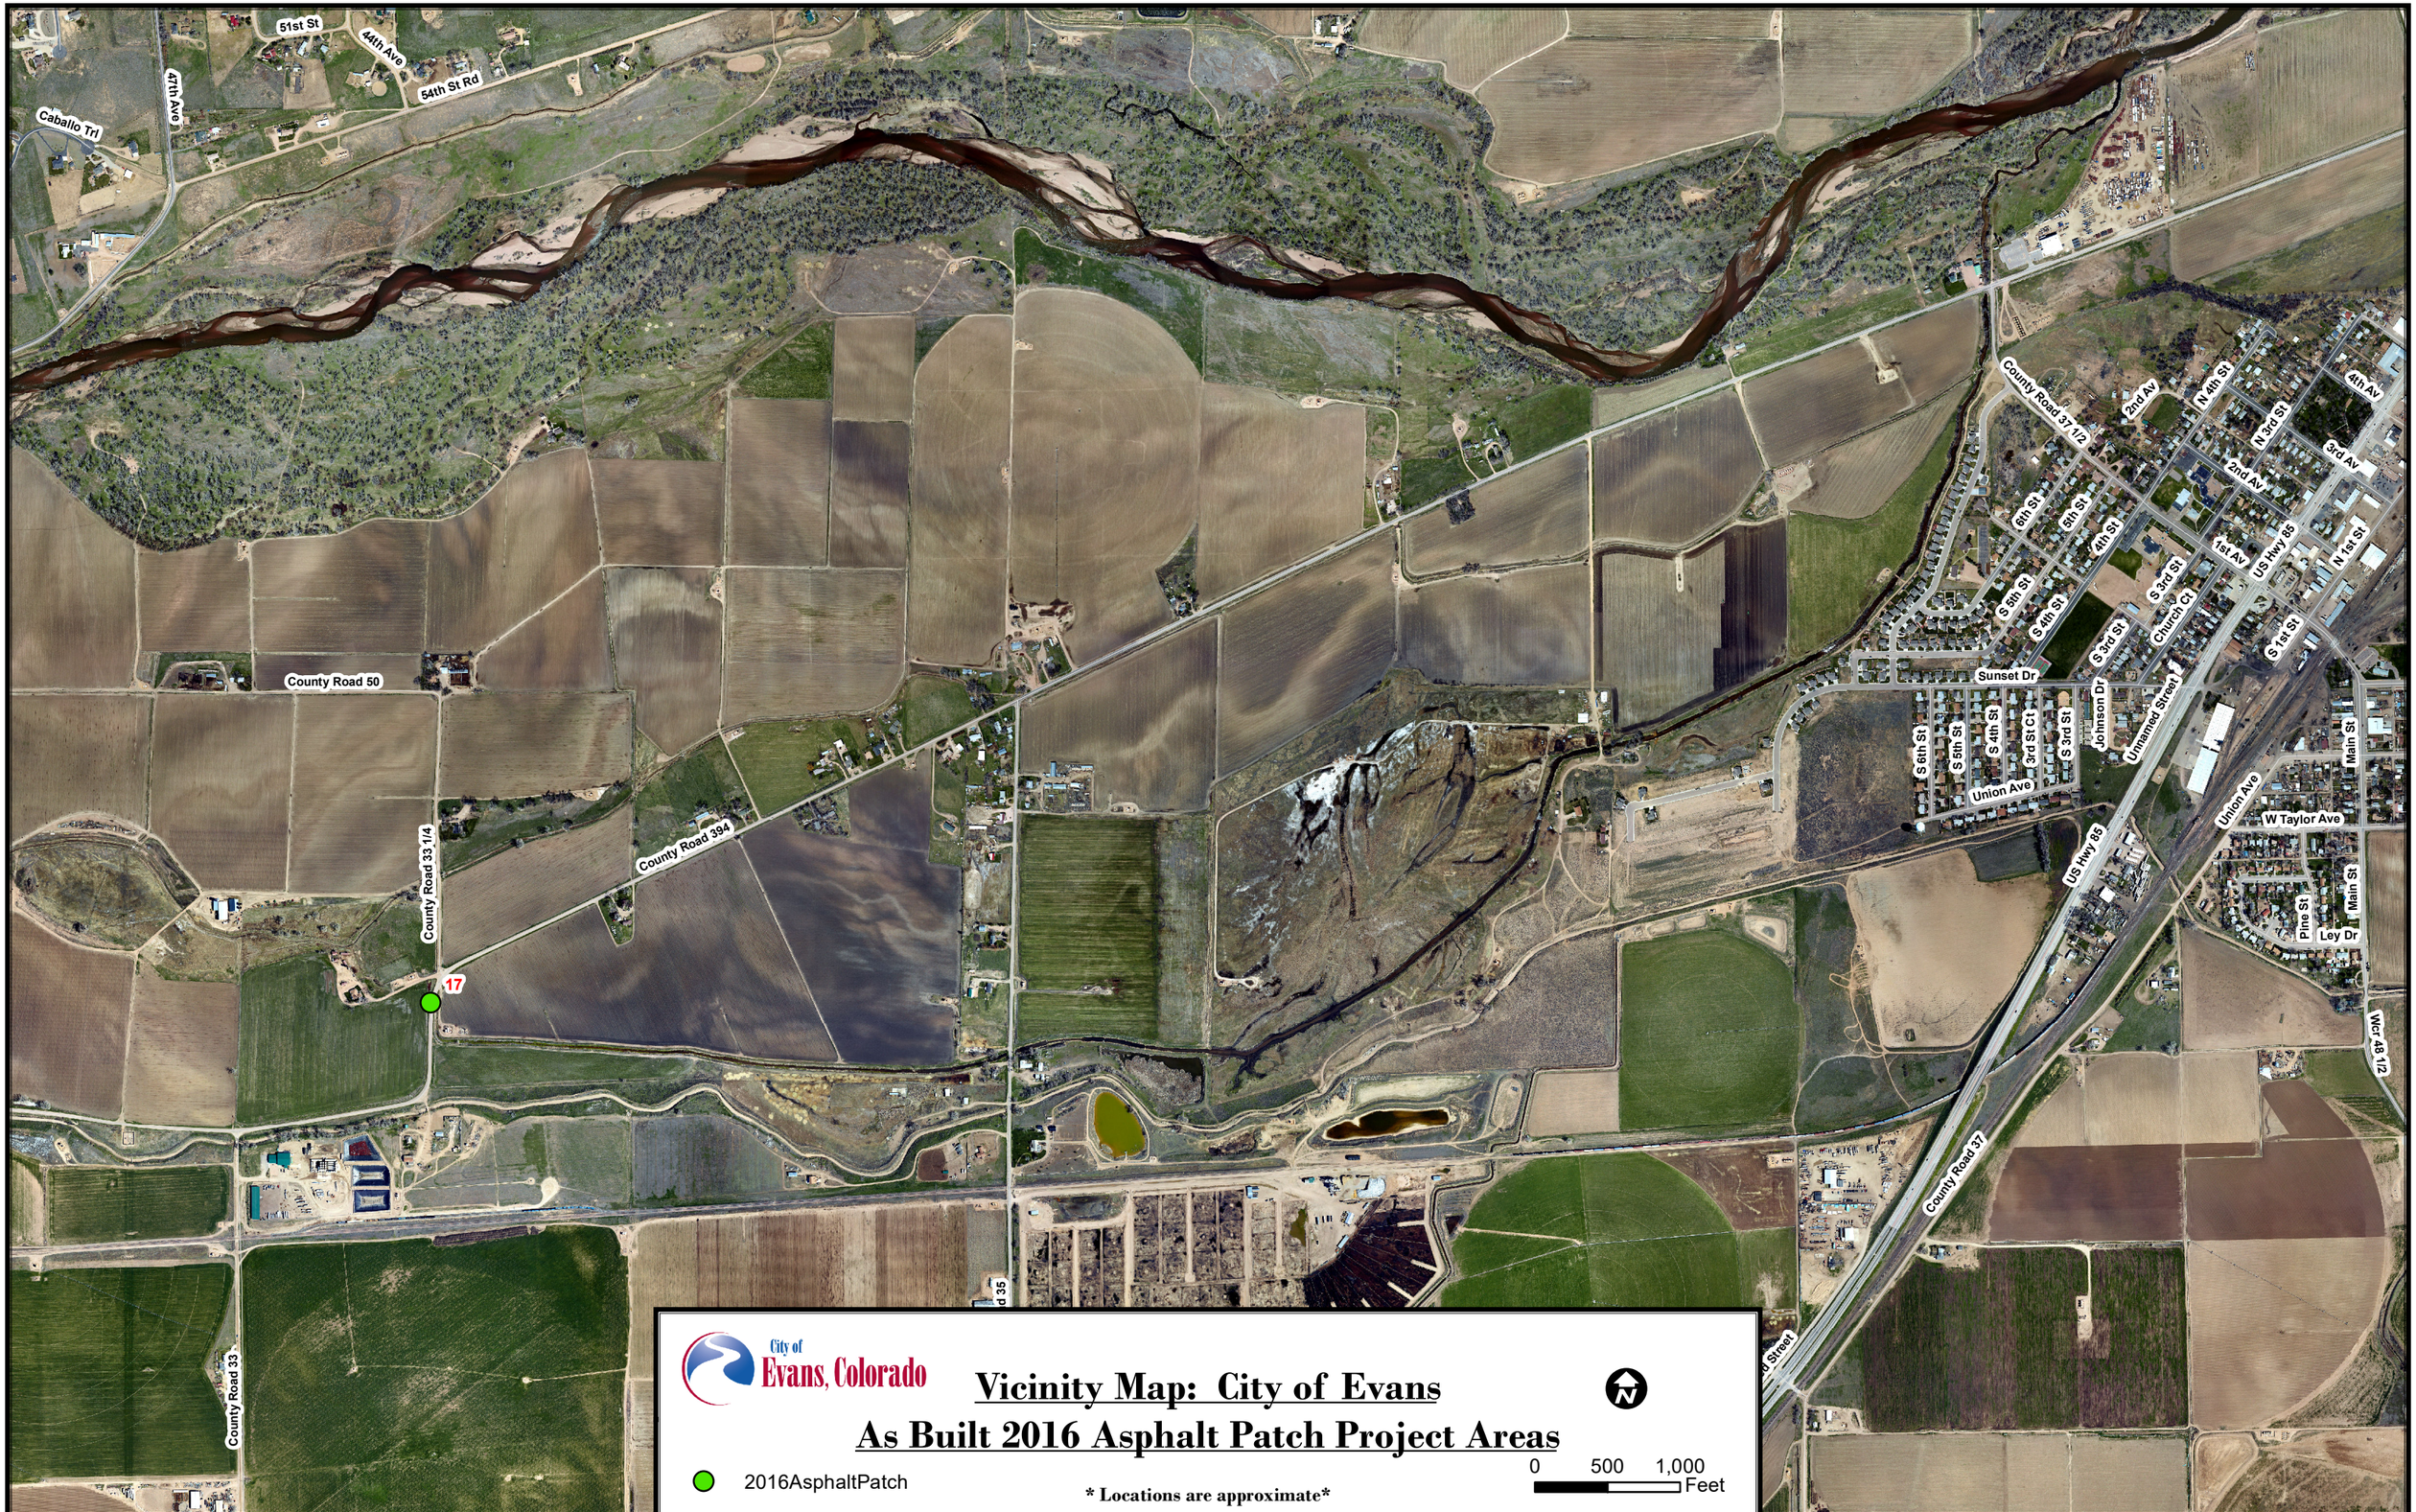
51st St
44th Ave
54th St Rd
47th Ave
Caballo Trl
County Road 50
County Road 394
County Road 33 1/4
County Road 33
17
County Road 37 1/2
2nd Av
N 4th St
N 3rd St
4th Av
3rd Av
2nd Av
6th St
5th St
4th St
1st Av
US Hwy 85
N 1st St
S 6th St
S 4th St
S 3rd St
Church Ct
S 1st St
Sunset Dr
S 6th St
S 5th St
S 4th St
3rd St Ct
S 3rd St
Johnson Dr
Unnamed Street
Union Ave
Main St
W Taylor Ave
Pine St
Ley Dr
Wcr 48 1/2
County Road 37
City of Evans, Colorado
Vicinity Map: City of Evans
As Built 2016 Asphalt Patch Project Areas
2016AsphaltPatch
* Locations are approximate*
0 500 1,000
Feet